

RECORD SET
DATE: DEC. 3, 2001

The information shown on these documents is a composite of the Contract Documents and information furnished by the Contractor following the completion of construction. The design professional in applying his seal to these record documents certifies that only information furnished by the Contractor has been incorporated into these record documents; however, no certification is made regarding the accuracy and completeness of the information shown. Additionally, the design professional does not certify that any of the information shown has been verified on site by the design professional or his agents, no certification is made that the work has been constructed in complete accordance with the Contract Documents, and no certification is made that these documents include all addenda, change orders, field directives, and other modifications which may have been made during the course of construction.

NOTE:
ALL OUTSIDE CORNERS ON INTERIOR CMU WALLS AND PARTITIONS WITHIN SECURE AREAS SHALL HAVE 2" BULLNOSE CORNERS UP TO 16'-0" A.F.F. (TYPICAL)

SECURITY WALL LEGEND

SECURE WALLS DENOTED THUS: - - - - - SHALL BE BUILT WITH REGULAR WEIGHT (125 PCF) RETAINING WALL TYPE BLOCKS WITH A 15% SAND CONTENT.

MINIMUM REINFORCING FOR 8" SECURE WALLS SHALL BE #4 REBARS @ 8" OC VERTICAL AND 3/16" DIA. HORIZONTAL JOINT REINFORCING @ 16" OC HORIZONTALLY.

MINIMUM REINFORCING FOR 12" SECURE WALLS SHALL BE #6 REBARS @ 8" OC VERTICAL AND 3/16" DIA. HORIZONTAL JOINT REINFORCING @ 16" OC HORIZONTALLY.

ALL CORES OF SECURE WALLS SHALL BE GROUTED SOLID. ALL SECURE WALLS SHALL EXTEND TO THE UNDERSIDE OF THE ROOF DECK. NO VOIDS WILL BE ACCEPTED. REFER TO STRUCTURAL DRAWINGS FOR ADDITIONAL INFORMATION.

REFER TO STRUCTURAL DRAWINGS FOR ADDITIONAL INFORMATION.



A SECURE PARTITION FIRST FLOOR PLAN
SCALE: 1/16"=1'-0"

FREEMANWHITE ARCHITECTS, d/b/a
Grier-Fripp Architects

charlotte nc


HENDERSON COUNTY
DETENTION CENTER

HENDERSONVILLE,
NORTH CAROLINA

SECURE PARTITION
FIRST FLOOR
PLAN

project number
■ 2271200

date
■ Sept. 13, 1999

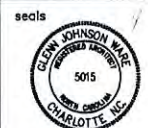

©1999 By
Grier-Fripp Architects

drawn by
■

checked by
■

revisions
■
■
cpr number
■


date
■

includes sheets
■
■
THIS DRAWING REFLECTS ALL CHANGES PREVIOUSLY MADE ON THIS PROJECT. ANY FUTURE CHANGES MUST BE MADE BY A SEPARATE DRAWING AND INDICATED BY A CIRCLE OR OTHERWISE REFERENCED BY THIS ONE.

sheet number

■ A2S.1

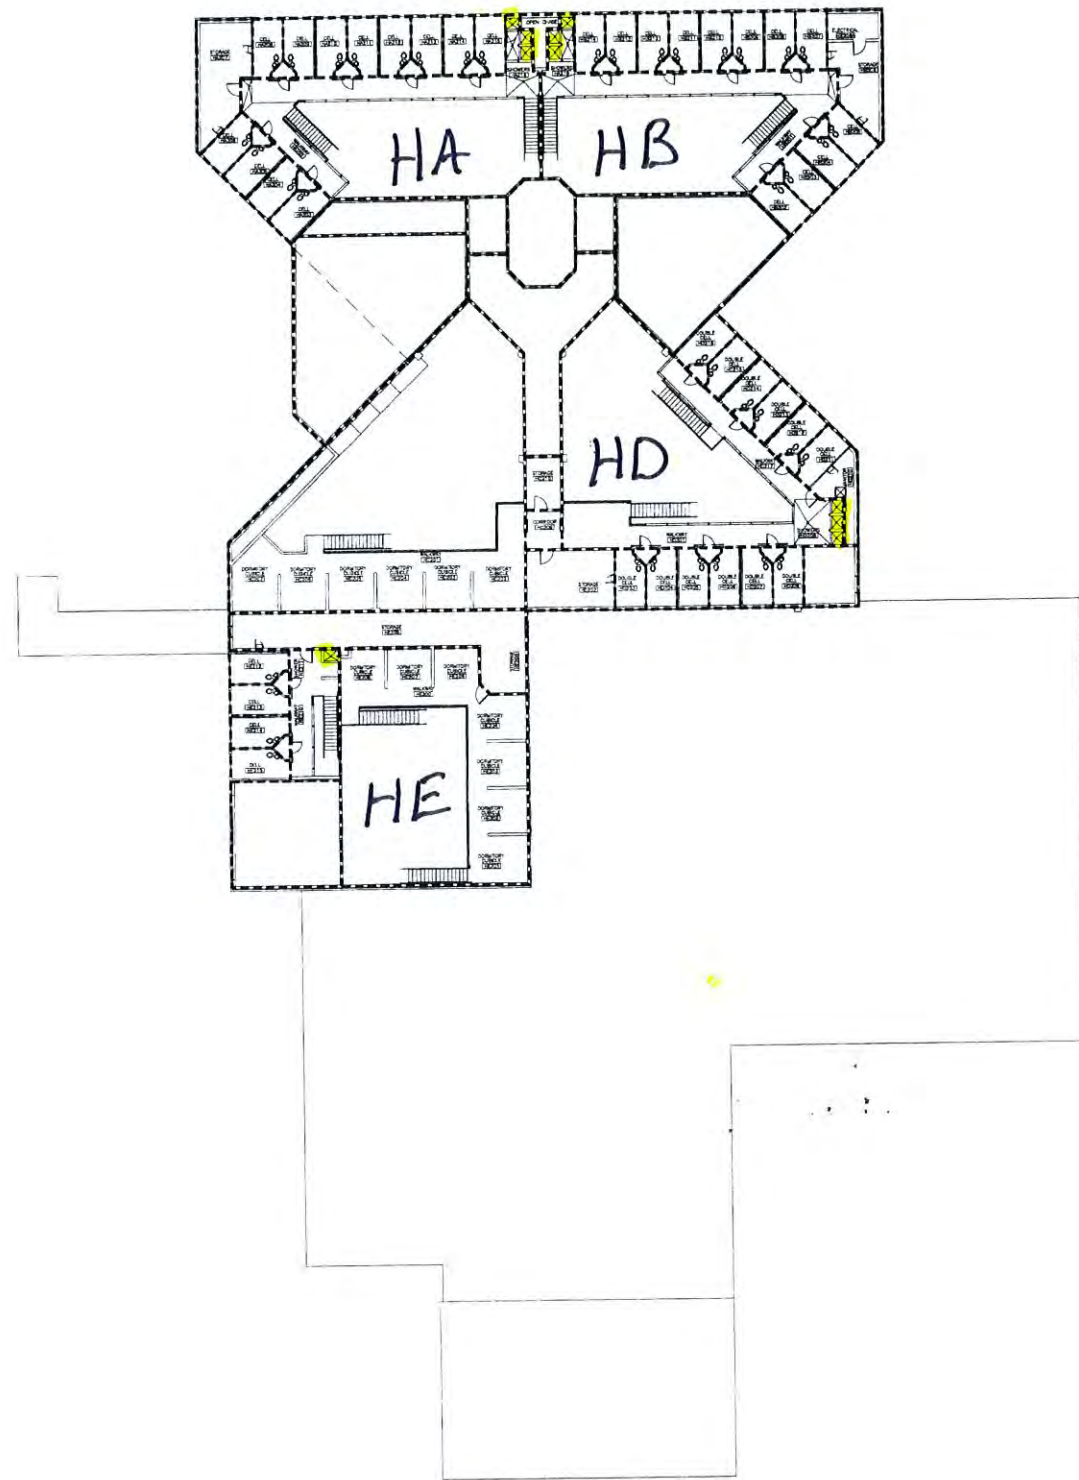

A SECURE PARTITION SECOND FLOOR PLAN
SCALE: 1/16"=1'-0"

RECORD SET
DATE: DEC. 3, 2001

The information shown on these documents is a composite of the Contract Documents and information furnished by the Contractor following the completion of construction. The design professional in applying his seal to these record documents certifies that only information furnished by the Contractor has been incorporated into these record documents; however, no certification is made regarding the accuracy and completeness of the information shown. Additionally, the design professional does not certify that any of the information shown has been verified on site by the design professional or his agents, no certification is made that the work has been constructed in complete accordance with the Contract Documents, and no certification is made that these documents include all addenda, change orders, field directives, and other modifications which may have been made during the course of construction.

NOTE:
ALL OUTSIDE CORNERS ON INTERIOR CMU WALLS AND PARTITIONS WITHIN SECURE AREAS SHALL HAVE 2" BULLNOSE CORNERS UP TO 16'-0" A.F.F. (TYPICAL)

SECURITY WALL LEGEND


SECURE WALLS DENOTED THIS [dashed line symbol] SHALL BE BUILT WITH REGULAR WEIGHT (125 PCF) RETAINING WALL TYPE BLOCKS WITH A 15% SAND CONTENT.

MINIMUM REINFORCING FOR 8" SECURE WALLS SHALL BE #4 REBARS @ 8" OC VERTICAL AND 3/16" DIA. HORIZONTAL JOINT REINFORCING @ 16" OC HORIZONTALLY.

MINIMUM REINFORCING FOR 12" SECURE WALLS SHALL BE #6 REBARS @ 8" OC VERTICAL AND 3/16" DIA. HORIZONTAL JOINT REINFORCING @ 16" OC HORIZONTALLY.

ALL CORNS OF SECURE WALLS SHALL BE GROUTED SOLID. ALL SECURE WALLS SHALL EXTEND TO THE UNDERSIDE OF THE ROOF DECK. NO VOIDS WILL BE ACCEPTED. REFER TO STRUCTURAL DRAWINGS FOR ADDITIONAL INFORMATION.

REFER TO STRUCTURAL DRAWINGS FOR ADDITIONAL INFORMATION.

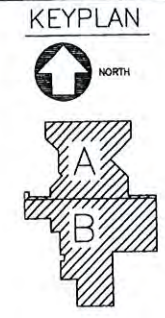

FREEMANWHITE ARCHITECTS, d/b/a
Grier-Fripp Architects

charlotte nc


HENDERSON COUNTY DETENTION CENTER

HENDERSONVILLE, NORTH CAROLINA

SECURE PARTITION SECOND FLOOR PLAN

project number
■ 2271200

date
■ Sept. 13, 1999

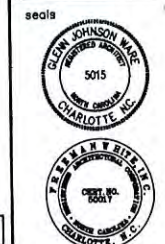

© 1999 by Grier-Fripp Architects

drawn by
■
checked by
■
revisions
■
■
■
■

cpr number
■
date
■
includes sheets
■
■
■

THE DRAWER ACCEPTS ALL CHANGES PRESENTED HEREON TO THIS SHEET. HEAVY AND MODERATE CHANGES AND ETC. ACCOMPANIED INTO THE CONTRACT BEFORE PROCEEDING WITH ANY WORK NOT SPECIFICALLY REFERENCED IN THIS SHEET.

sheet number
■ A2S.2

**HENDERSON COUNTY
 DETENTION CENTER**

HENDERSONVILLE,
 NORTH CAROLINA

**FIRST FLOOR
 PLAN AREA "A"**

project number
 ■ 2271200

date
 ■ Sept. 13, 1999

seals



© 1999 by Grier-Fripp Architects

drawn by

checked by

revisions

cpr number

date

includes sheets

sheet number

■ A2.1A

LEGEND



- 1-HR RATED WALL
- 1-HR RATED SMOKE BARRIER
- SMOKE TIGHT WALL
- EXISTING WALL TO REMAIN
- EXISTING WALL TO BE REMOVED
- NEW WALL CONSTRUCTION TO UNDERSIDE OF STRUCTURE ABOVE
- XX PARTITION TYPE DESIGNATION - SEE DETAIL SHTS. A8.10 & A8.11
- HOLLOW METAL WINDOW TYPE - SEE SHIT. A8.8
- ◻ SECURITY HOLLOW METAL WINDOW TYPE - SEE SHITS. A12.3 & A12.4
- ⊕ DOOR TYPE OR NUMBER - SEE SHITS. A8.4 & A8.5
- M-1 MILLWORK ELEVATION - SEE A11 SERIES DWGS.
- ±000.00' SPOT ELEVATION

NOTE:
 ALL OUTSIDE CORNERS ON INTERIOR CMU WALLS AND PARTITIONS WITHIN SECURE AREAS SHALL HAVE 2" BULLNOSE CORNERS UP TO 8'-8" A.F.F. (TYPICAL)

RECORD SET
 DATE: DEC. 3, 2001

The information shown on these documents is a composite of the Contract Documents and information furnished by the Contractor following the completion of construction. The design professional in applying his seal to these record documents certifies that only information furnished by the Contractor has been incorporated into these record documents; however, no certification is made regarding the accuracy and completeness of the information shown. Additionally, the design professional does not certify that any of the information shown has been verified on site by the design professional or his agents, no certification is made that the work has been constructed in complete accordance with the Contract Documents, and no certification is made that these documents include all addenda, change orders, field directives, and other modifications which may have been made during the course of construction.

KEYPLAN

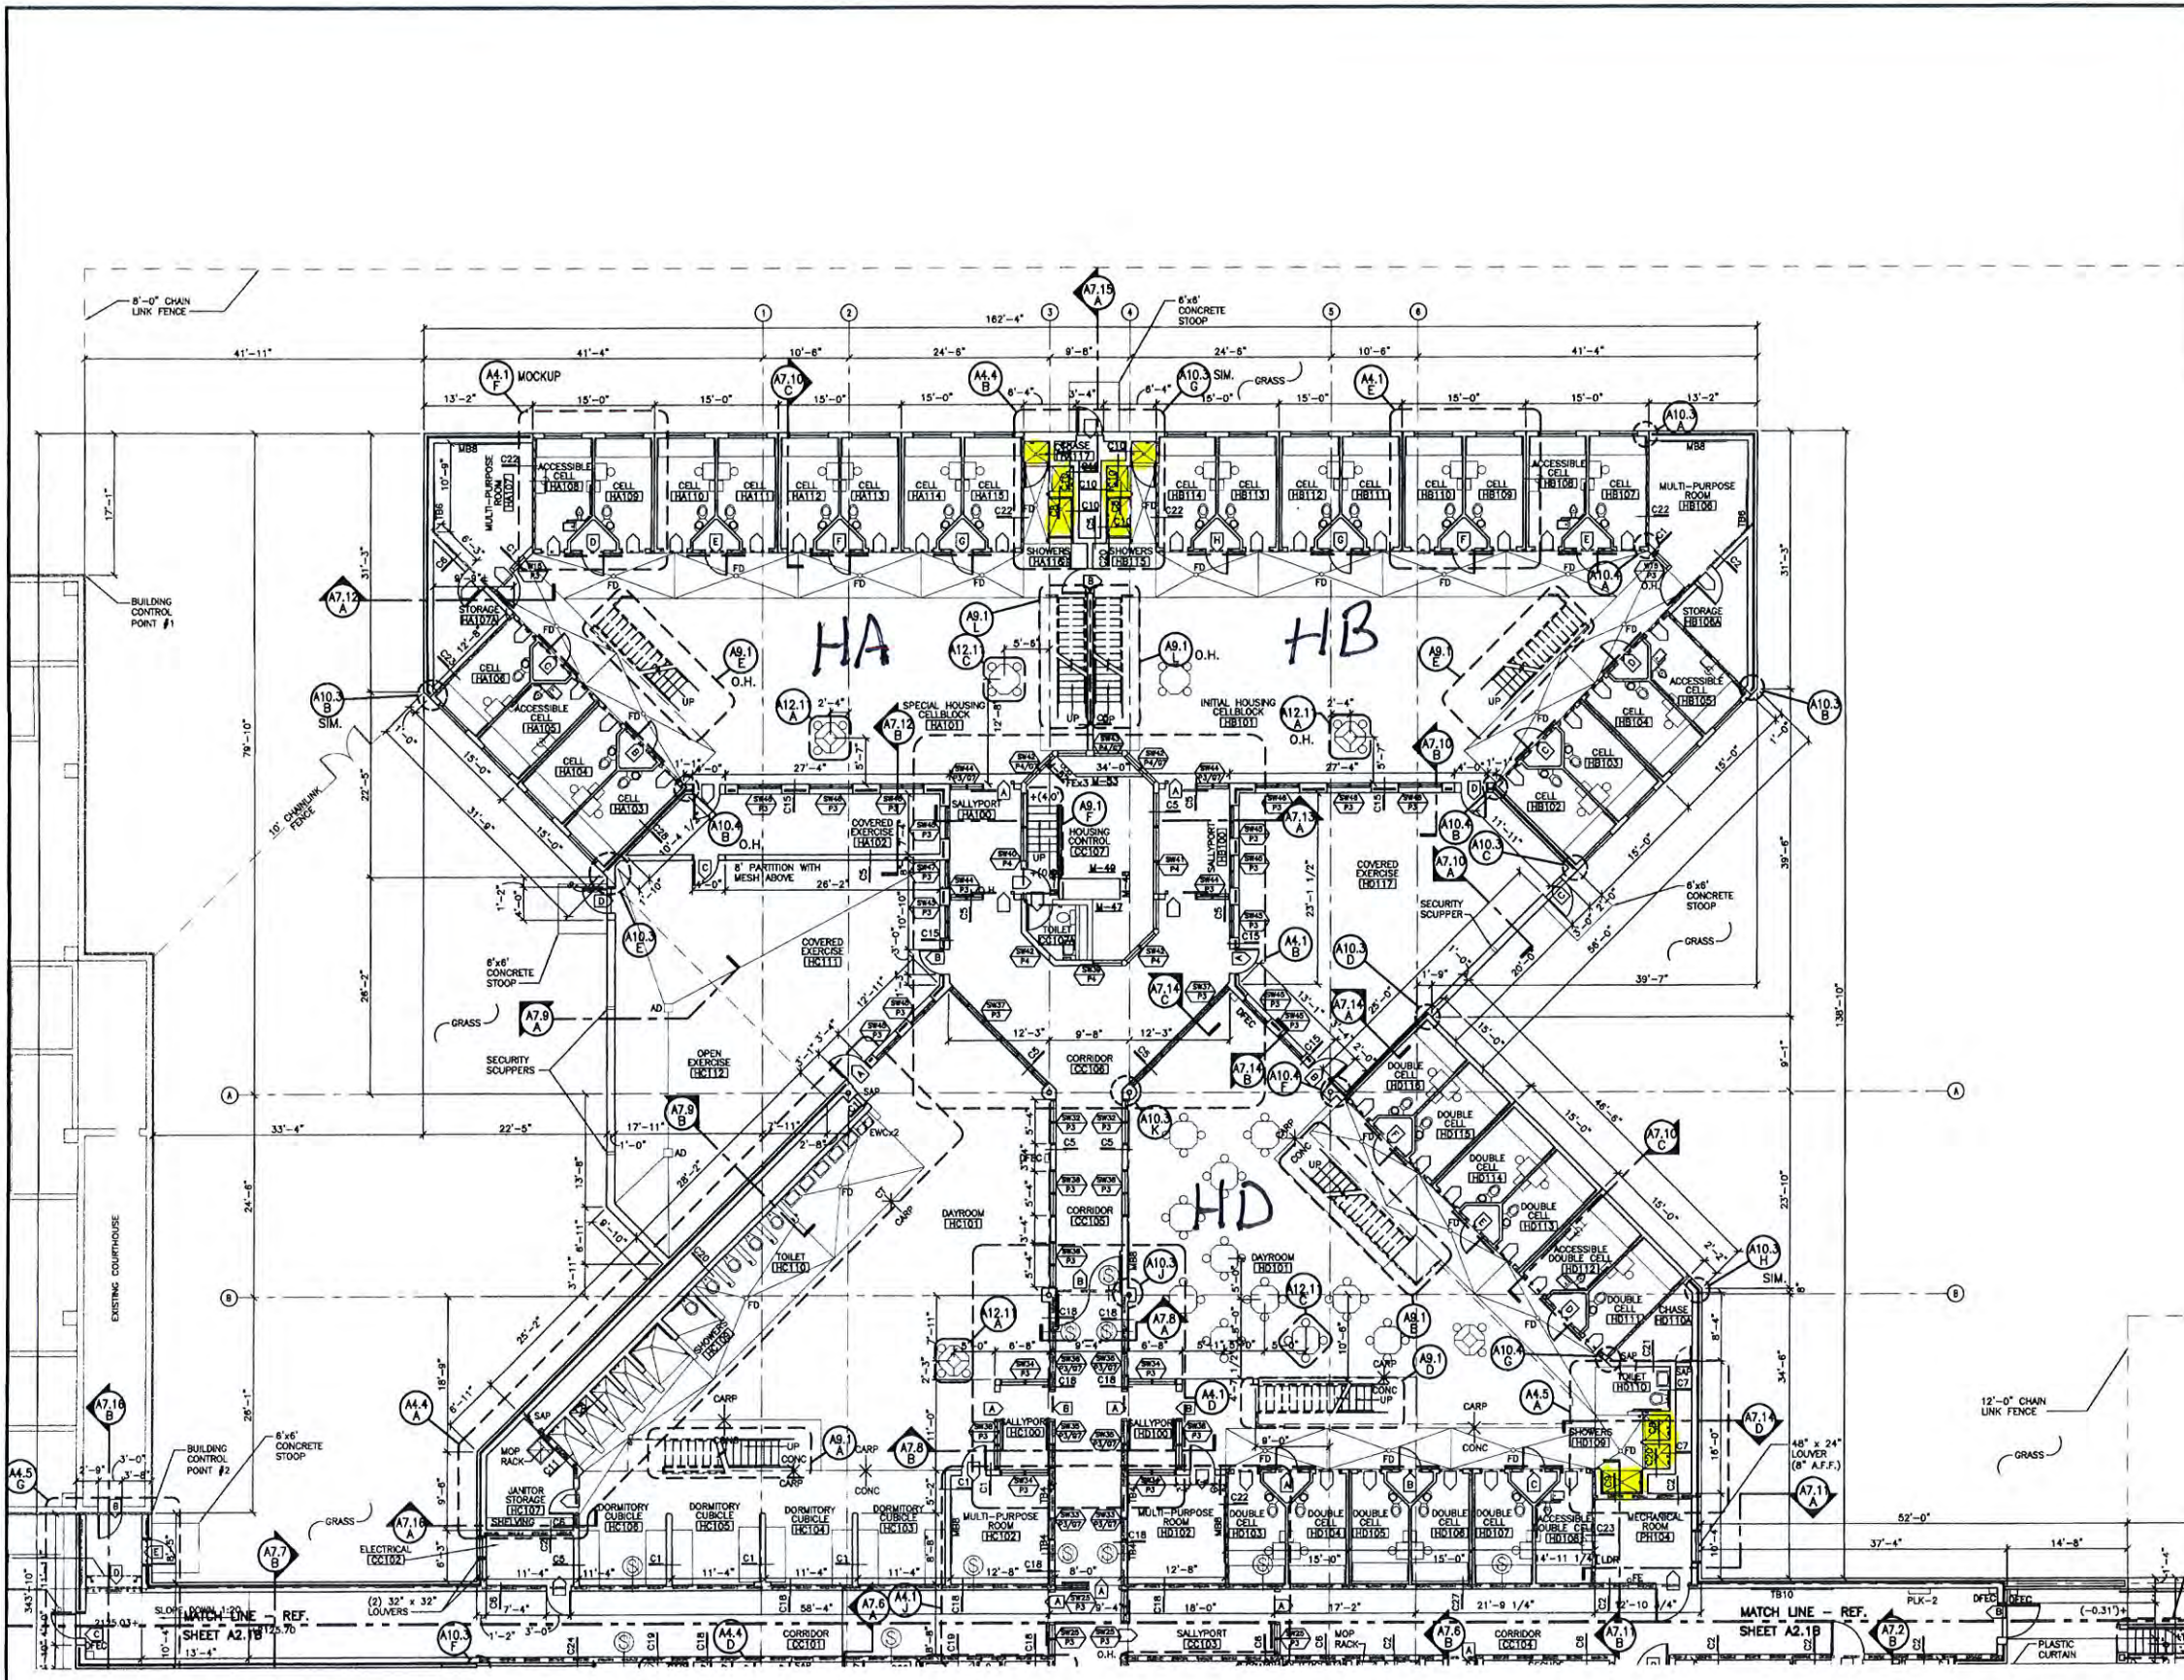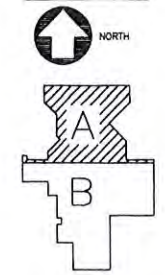

A FIRST FLOOR PLAN
 SCALE: 1/8"=1'-0"

charlotte nc

**HENDERSON COUNTY
 DETENTION CENTER**

HENDERSONVILLE,
 NORTH CAROLINA

**FIRST FLOOR
 PLAN AREA "B"**

project number
 2271200

date
 Sept. 13, 1999

seals



© 1999 by
 Grier-Fripp Architects

drawn by

checked by

revisions


cpr number

date

includes sheets

sheet number

A2.1B

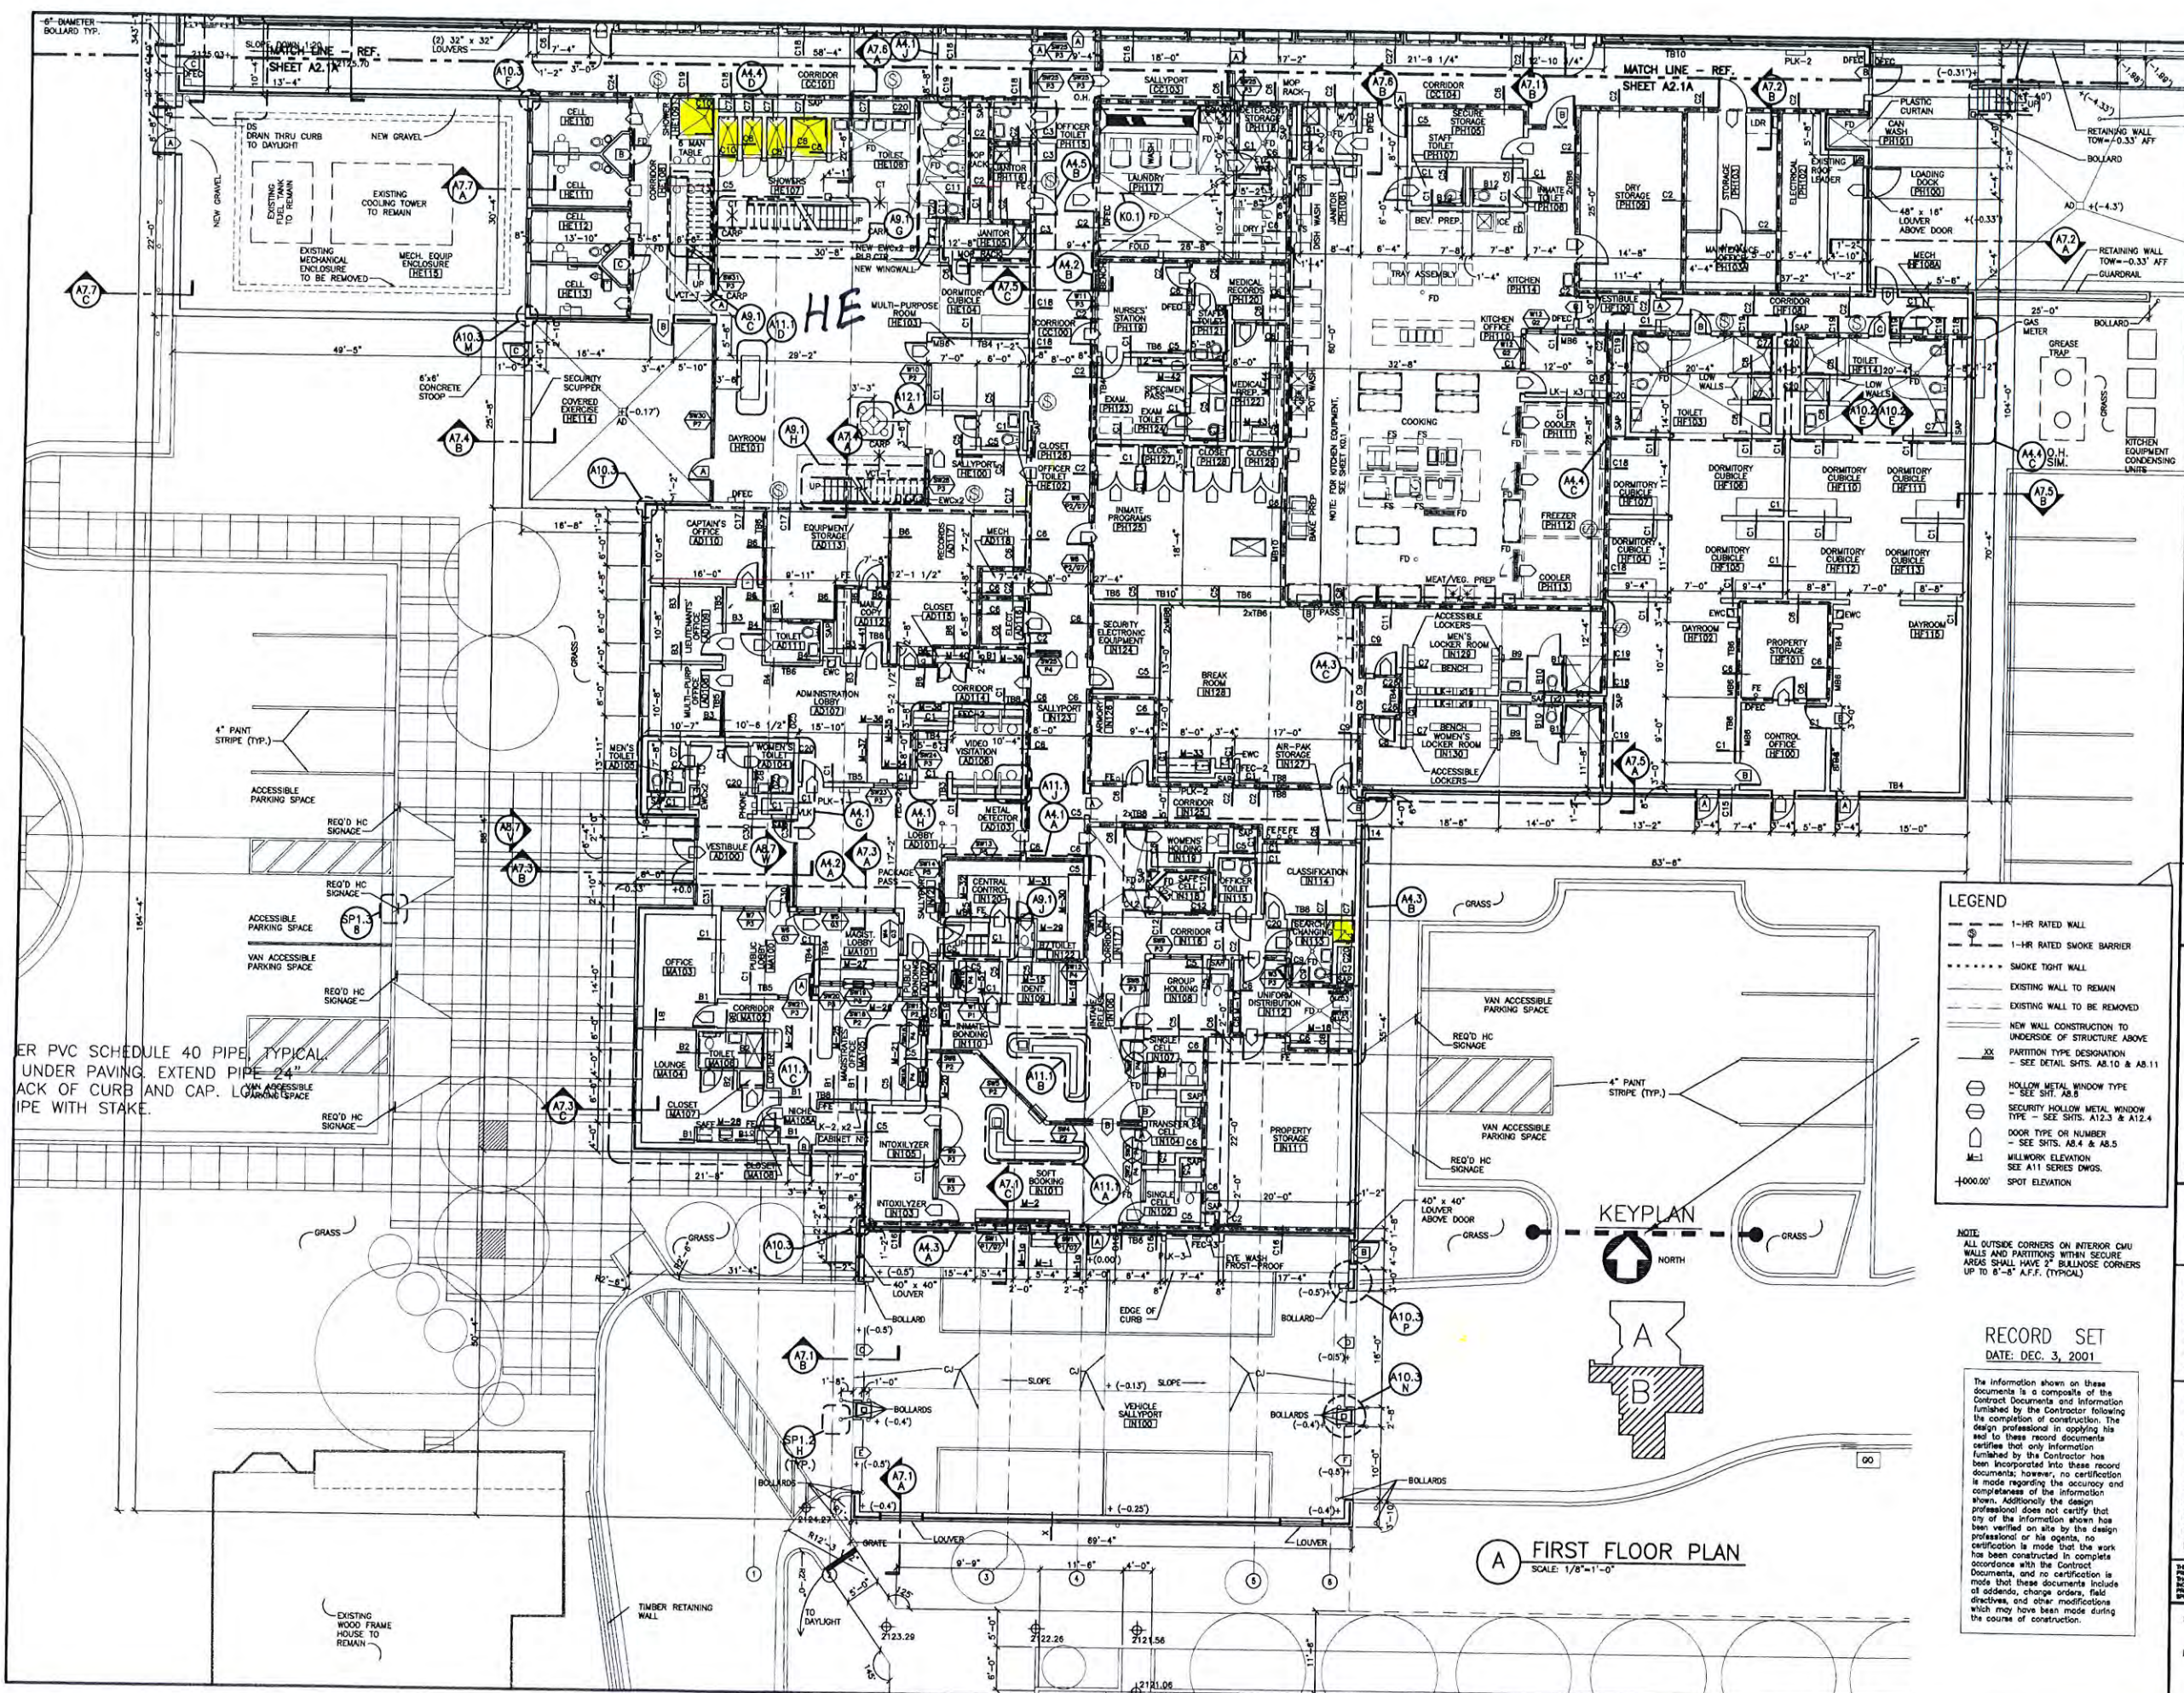

LEGEND

- 1-HR RATED WALL
- 1-HR RATED SMOKE BARRIER
- SMOKE TIGHT WALL
- EXISTING WALL TO REMAIN
- EXISTING WALL TO BE REMOVED
- NEW WALL CONSTRUCTION TO UNDERSIDE OF STRUCTURE ABOVE
- PARTITION TYPE DESIGNATION - SEE DETAIL SHTS. A8.10 & A8.11
- HOLLOW METAL WINDOW TYPE - SEE SHIT. A8.5
- SECURITY HOLLOW METAL WINDOW TYPE - SEE SHITS. A12.3 & A12.4
- DOOR TYPE OR NUMBER - SEE SHITS. A8.4 & A8.5
- M-1 MILLWORK ELEVATION SEE A11 SERIES DWGS.
- +000.00' SPOT ELEVATION

NOTE:
 ALL OUTSIDE CORNERS ON INTERIOR CMU WALLS AND PARTITIONS WITHIN COURSE AREAS SHALL HAVE 2" BULKHEAD CORNERS UP TO 6'-6" A.F.F. (TYPICAL)

RECORD SET
 DATE: DEC. 3, 2001

The information shown on these documents is a composite of the Contract Documents and information furnished by the Contractor following the completion of construction. The design professional in applying his seal to these record documents certifies that only information furnished by the Contractor has been incorporated into these record documents; however, no certification is made regarding the accuracy and completeness of the information shown. Additionally the design professional does not certify that any of the information shown has been verified on site by the design professional or his agents, no certification is made that the work has been constructed in complete accordance with the Contract Documents, and no certification is made that these documents include all addenda, change orders, field directives, and other modifications which may have been made during the course of construction.

A FIRST FLOOR PLAN
 SCALE: 1/8"=1'-0"

ER PVC SCHEDULE 40 PIPE, TYPICAL,
 UNDER PAVING. EXTEND PIPE 24"
 BACK OF CURB AND CAP. LOUVER
 PIPE WITH STAKE.

REQUIRE HO SIGNAGE

ACCESSIBLE PARKING SPACE

VAN ACCESSIBLE PARKING SPACE

REQUIRE HO SIGNAGE

ACCESSIBLE PARKING SPACE

VAN ACCESSIBLE PARKING SPACE

REQUIRE HO SIGNAGE


ACCESSIBLE PARKING SPACE

VAN ACCESSIBLE PARKING SPACE

REQUIRE HO SIGNAGE

ACCESSIBLE PARKING SPACE

VAN ACCESSIBLE PARKING SPACE

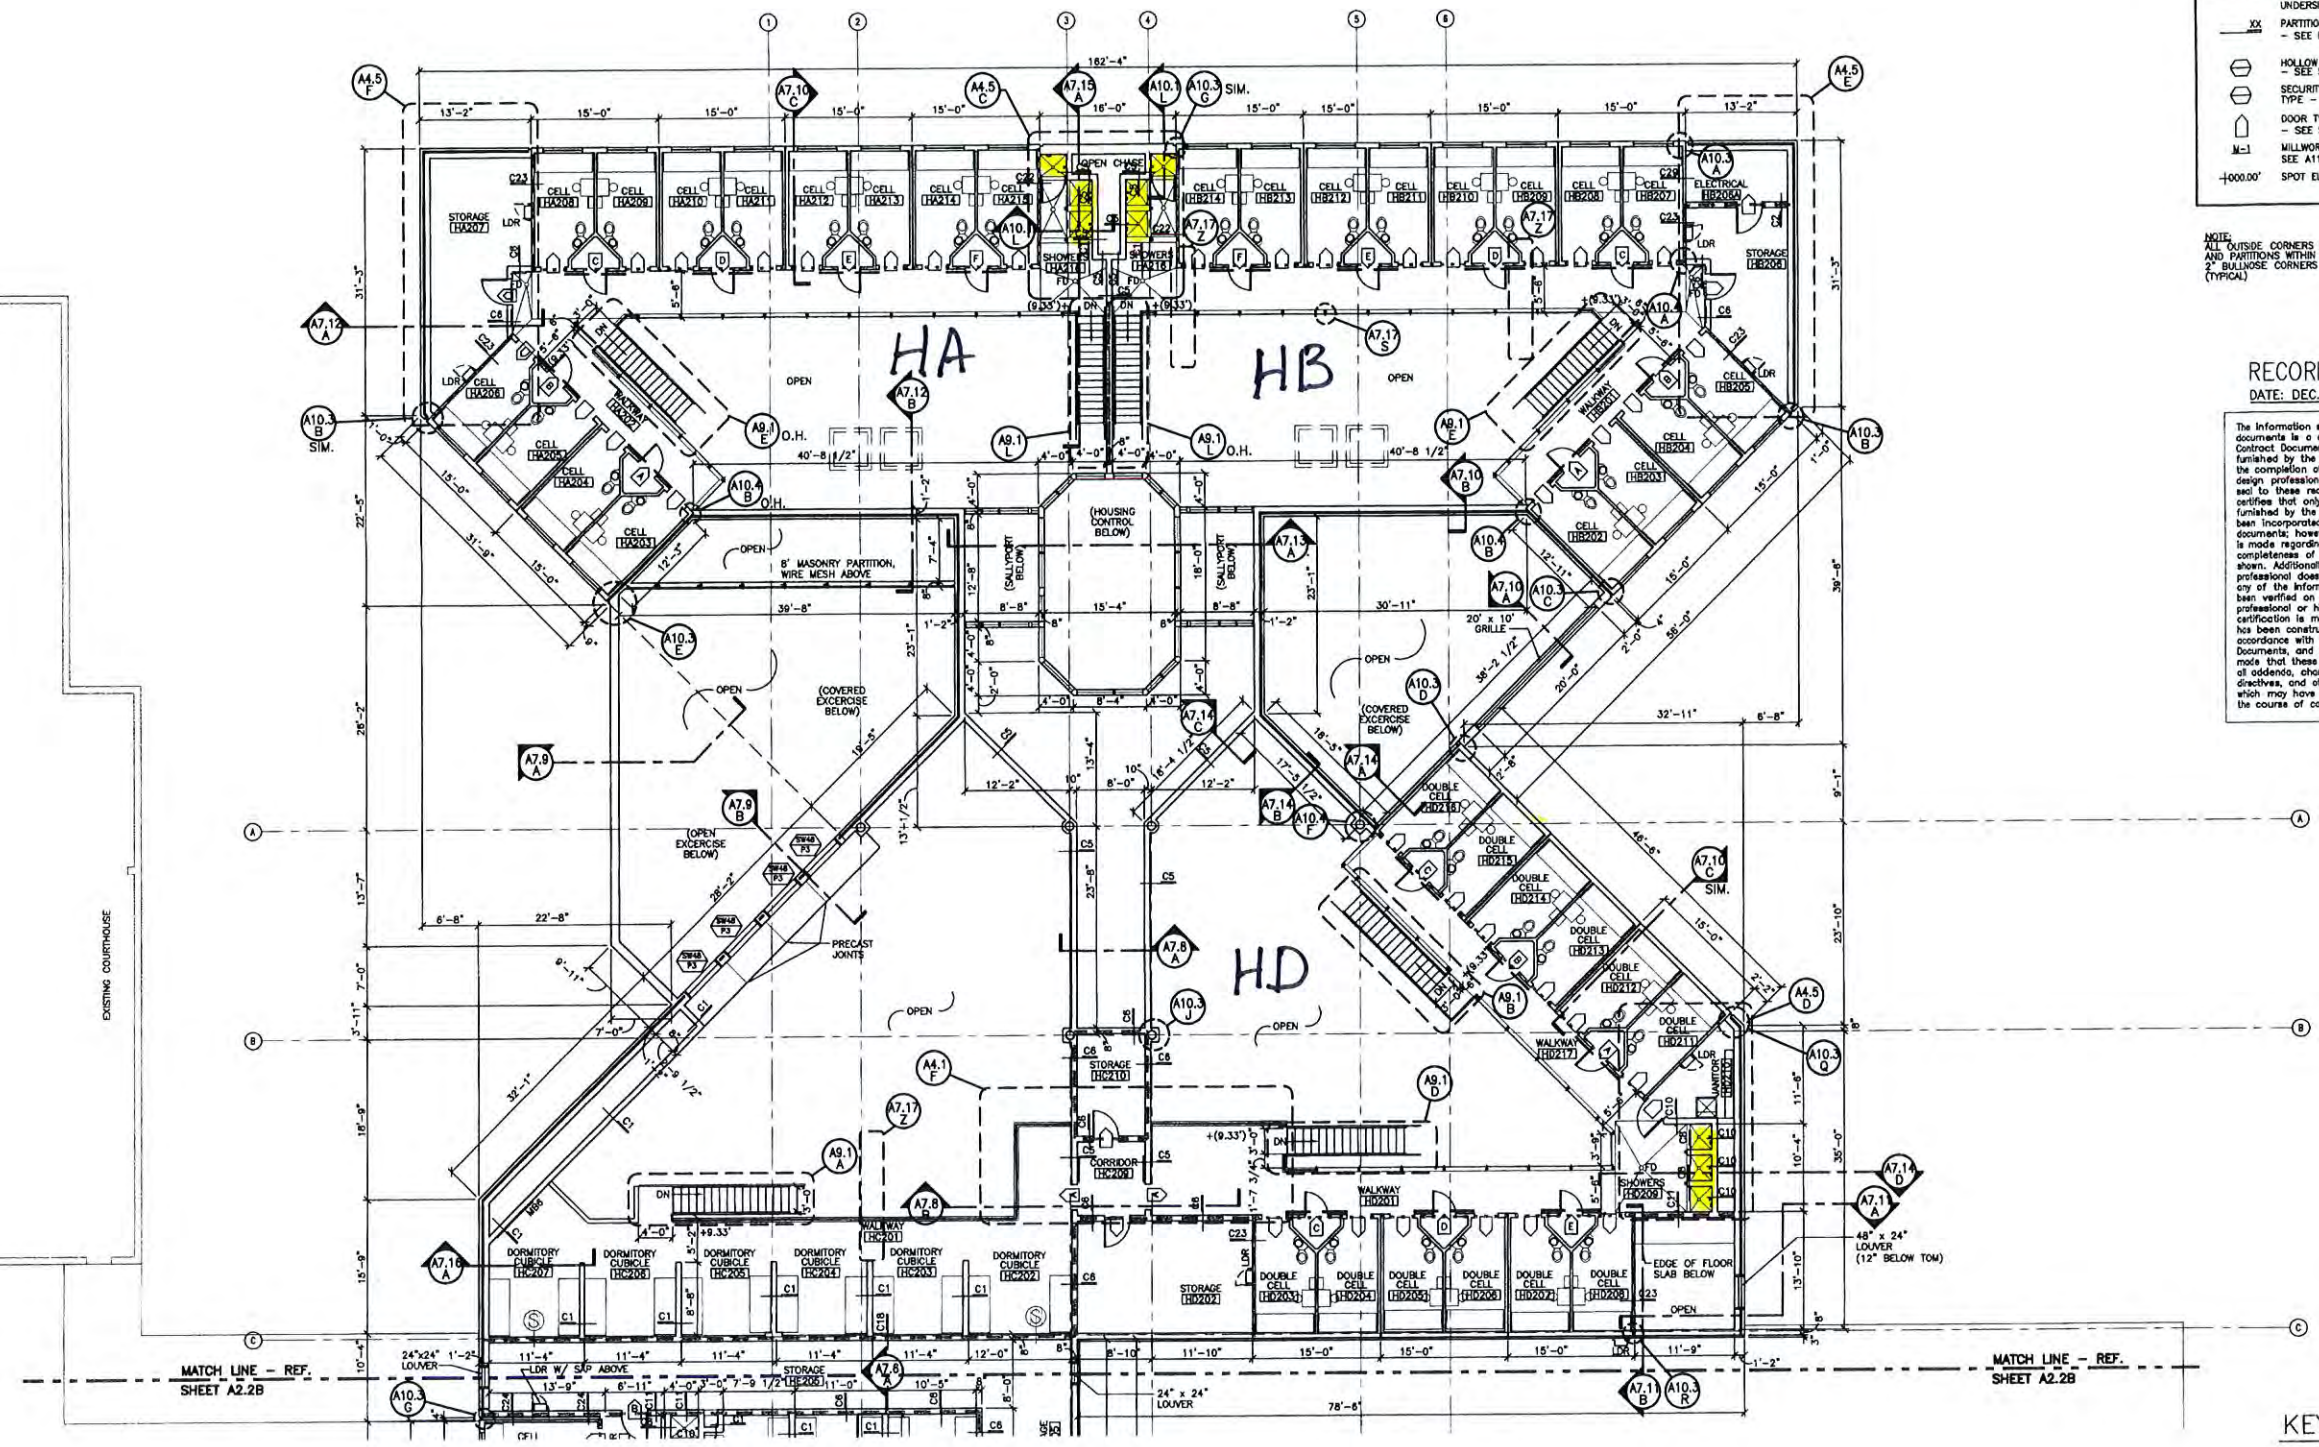

- LEGEND**
- 1-HR RATED WALL
 - 1-HR RATED SMOKE BARRIER
 - SMOKE TIGHT WALL
 - EXISTING WALL TO REMAIN
 - - - EXISTING WALL TO BE REMOVED
 - NEW WALL CONSTRUCTION TO UNDERSIDE OF STRUCTURE ABOVE
 - XX PARTITION TYPE DESIGNATION - SEE DETAIL SHTS. A8.10 & A8.11
 - HOLLOW METAL WINDOW TYPE - SEE SHT. A8.8
 - SECURITY HOLLOW METAL WINDOW TYPE - SEE SHTS. A12.3 & A12.4
 - DOOR TYPE OR NUMBER - SEE SHTS. A8.4 & A8.5
 - M-1 MILLWORK ELEVATION - SEE A11 SERIES DWGS.
 - 1000.00' SPOT ELEVATION

NOTE: ALL OUTSIDE CORNERS ON CMU INTERIOR WALLS AND PARTITIONS WITHIN SECUR AREAS SHALL HAVE 2" BULLNOSE CORNERS UP TO 16'-0" A.F.F. (TYPICAL)

RECORD SET
DATE: DEC. 3, 2001

The information shown on these documents is a composite of the Contract Documents and information furnished by the Contractor following the completion of construction. The design professional in applying his seal to these record documents certifies that only information furnished by the Contractor has been incorporated into these record documents; however, no certification is made regarding the accuracy and completeness of the information shown. Additionally the design professional does not certify that any of the information shown has been verified on site by the design professional or his agents, no certification is made that the work has been constructed in complete accordance with the Contract Documents, and no certification is made that these documents include all addenda, change orders, field directives, and other modifications which may have been made during the course of construction.

FREEMANWHITE ARCHITECTS, A/76/A
Grier-Fripp Architects
charlotte nc

HENDERSON COUNTY DETENTION CENTER

HENDERSONVILLE, NORTH CAROLINA

SECOND FLOOR PLAN AREA "A"

project number ■ 2271200
date ■ Sept. 13, 1999





© 1999 by Grier-Fripp Architects
drawn by ■
checked by ■
revisions ■
■
■
■
■

cpr number ■
date ■
includes sheets ■
■
■
■

sheet number ■ **A2.2A**

A SECOND FLOOR PLAN
SCALE: 1/8"=1'-0"

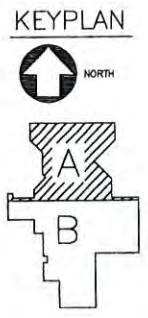

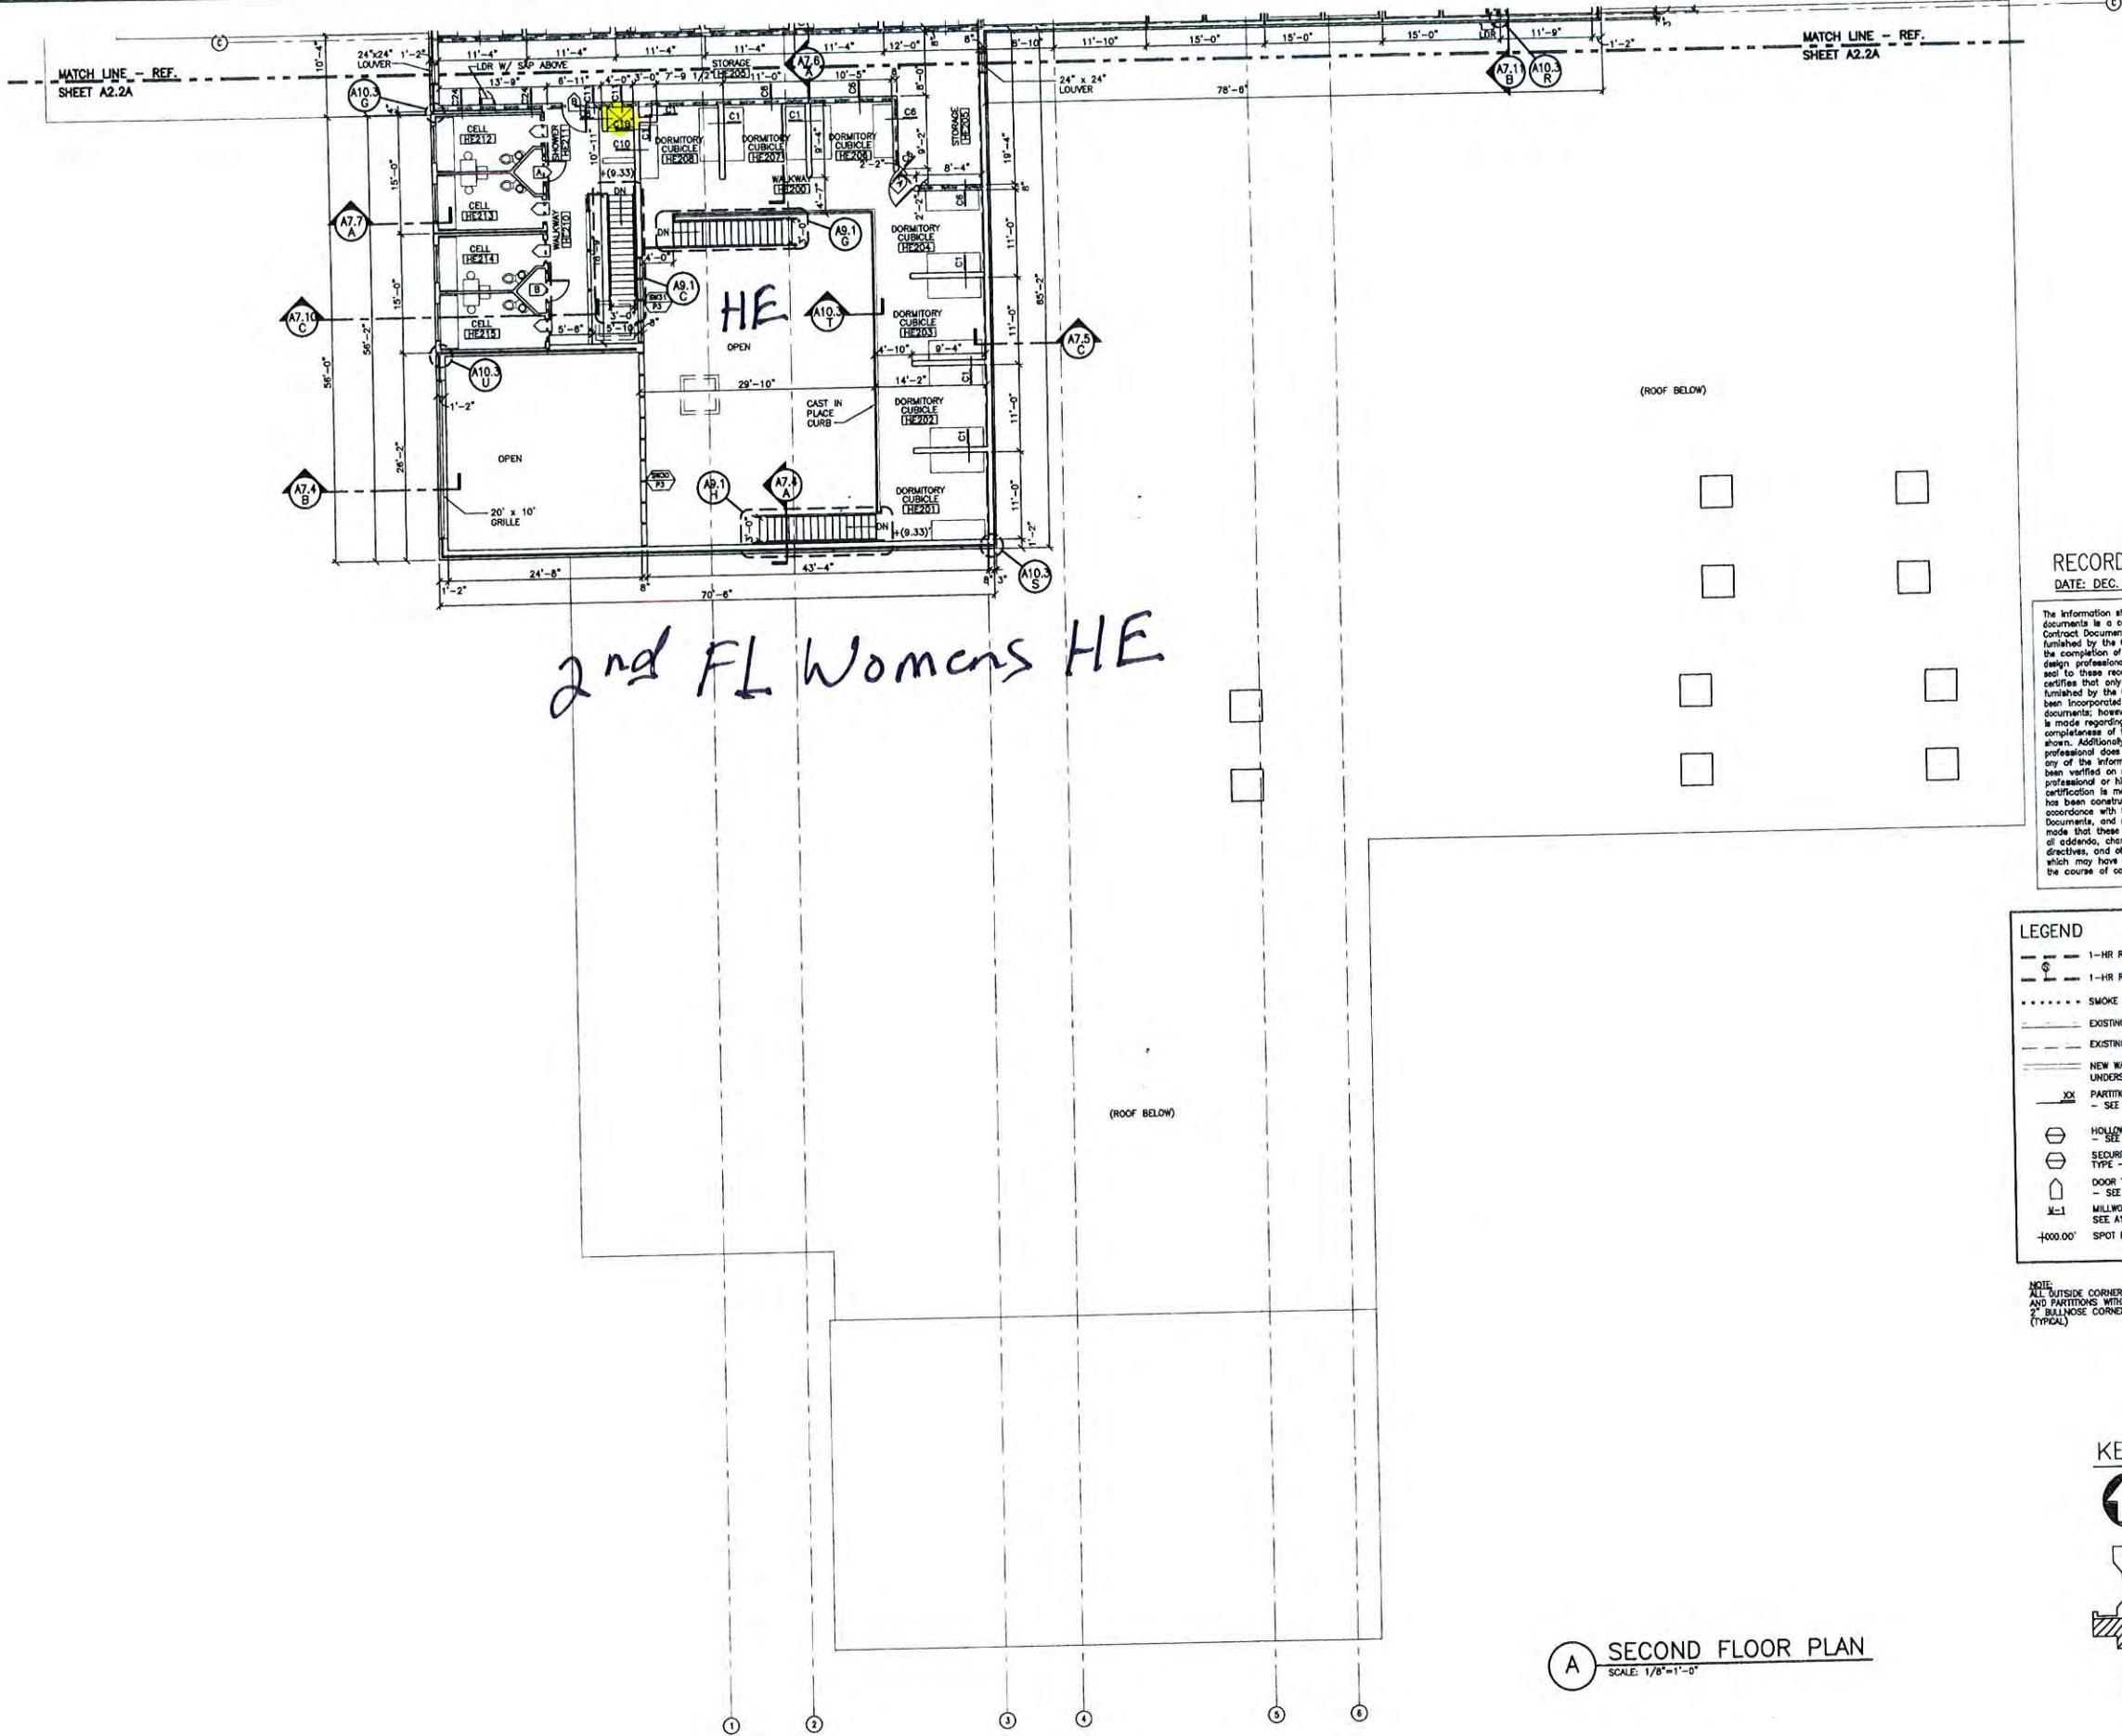

2nd FL Womens HE

RECORD SET
DATE: DEC. 3, 2001

The information shown on these documents is a composite of the Contract Documents and information furnished by the Contractor following the completion of construction. The design professional in applying the seal to these record documents certifies that only information furnished by the Contractor has been incorporated into these record documents; however, no certification is made regarding the accuracy and completeness of the information shown. Additionally, the design professional does not certify that any of the information shown has been verified on site by the design professional or his agents, no certification is made that the work has been constructed in complete accordance with the Contract Documents, and no certification is made that these documents include all addenda, change orders, field directives, and other modifications which may have been made during the course of construction.

- LEGEND**
- 1-HR RATED WALL
 - 1-HR RATED SMOKE BARRIER
 - SMOKE TIGHT WALL
 - EXISTING WALL TO REMAIN
 - - - - EXISTING WALL TO BE REMOVED
 - NEW WALL CONSTRUCTION TO UNDERSIDE OF STRUCTURE ABOVE
 - XX PARTITION TYPE DESIGNATION - SEE DETAIL SHTS. A8.10 & A8.11
 - HOLLOW METAL WINDOW TYPE - SEE SHT. A8.8
 - SECURITY HOLLOW METAL WINDOW TYPE - SEE SHTS. A12.3 & A12.4
 - DOOR TYPE OR NUMBER - SEE SHTS. A8.4 & A8.5
 - ±1 MILLWORK ELEVATION SEE A11 SERIES DWGS.
 - +400.00' SPOT ELEVATION

NOTE:
ALL OUTSIDE CORNERS ON CMU INTERIOR WALLS AND PARTITIONS WITHIN SECUR. AREAS SHALL HAVE 7" BALLNOSE CORNERS UP TO 16'-0" A.F.F. (TYPICAL)



A SECOND FLOOR PLAN
SCALE: 1/8"=1'-0"

FREEMANWHITE ARCHITECTS, d/b/a
Grier-Fripp Architects

charlotte nc

HENDERSON COUNTY
DETENTION CENTER

HENDERSONVILLE,
NORTH CAROLINA

SECOND FLOOR
PLAN
AREA "B"

project number
■ 2271200

date
■ Sept. 13, 1999



©1999 by Grier-Fripp Architects

drawn by

checked by

revisions


cpr number

date


includes sheets

sheet number


■ A2.2B

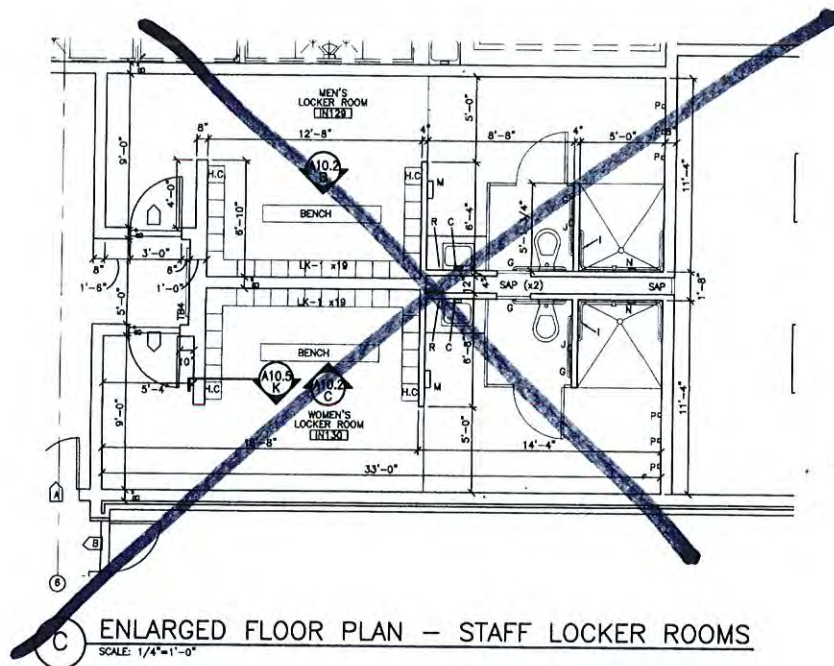

C ENLARGED FLOOR PLAN - STAFF LOCKER ROOMS
SCALE: 1/4"=1'-0"

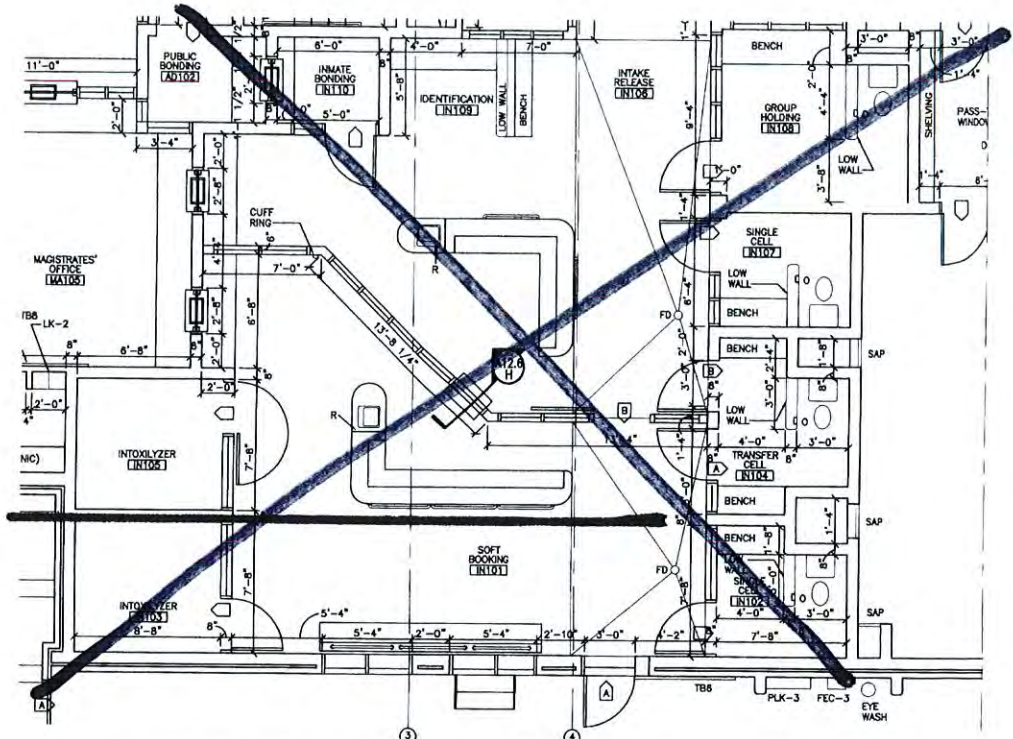

A ENLARGED FLOOR PLAN - BOOKING AT INTAKE
SCALE: 1/4"=1'-0"

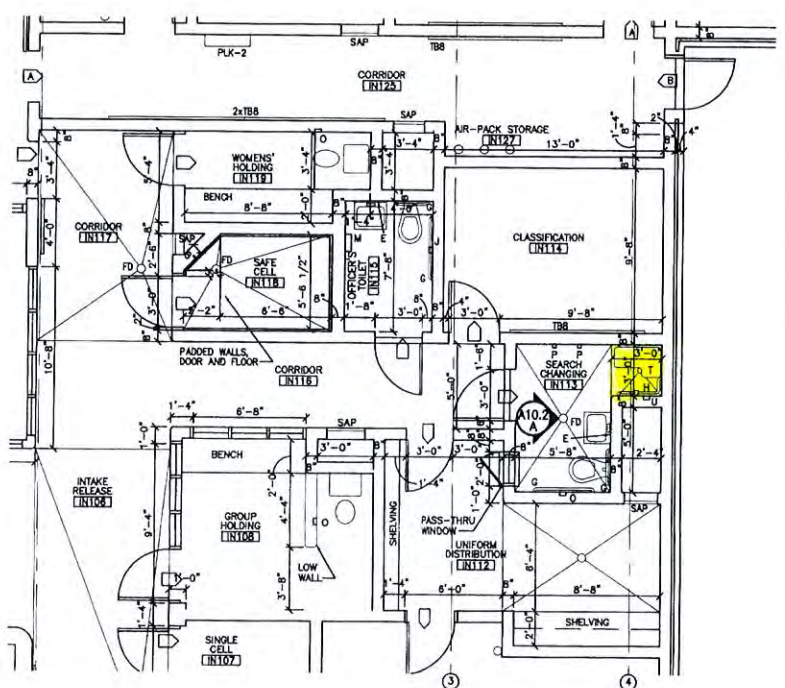

B ENLARGED FLOOR PLAN - GROUP HOLDING AT INTAKE
SCALE: 1/4"=1'-0"

Booking

RECORD SET
DATE: DEC. 3, 2001

The information shown on these documents is a composite of the Contract Documents and information furnished by the Contractor following the completion of construction. The design professional in applying his seal to these record documents certifies that only information furnished by the Contractor has been incorporated into these record documents; however, no certification is made regarding the accuracy and completeness of the information shown. Additionally the design professional does not certify that any of the information shown has been verified on site by the design professional or his agents, no certification is made that the work has been constructed in complete accordance with the Contract Documents, and no certification is made that these documents include all addenda, change orders, field directives, and other modifications which may have been made during the course of construction.

FREEMANWHITE ARCHITECTS, d/b/a
Grier-Fripp Architects

charlotte nc

HENDERSON COUNTY
DETENTION CENTER

HENDERSONVILLE,
NORTH CAROLINA

ENLARGED
FLOOR PLANS

INTAKE
& LOCKERS

project number
■ 2271200
date
■ Sept. 13, 1999

seals

© 1999 by
Grier-Fripp Architects



drawn by
■
checked by
■

revisions
■
■
■
■


cpr number
■
date
■
includes sheets
■
■
■

sheet number
■ A4.3


THIS DRAWING REFLECTS ALL CHANGES
PROPERLY MADE ON THIS SHEET. OTHER
REVISIONS TO THIS DRAWING SHALL BE
RECORDED IN THE PROJECT RECORDS AND
SPECIFICALLY REFERENCED BY THIS SHEET.

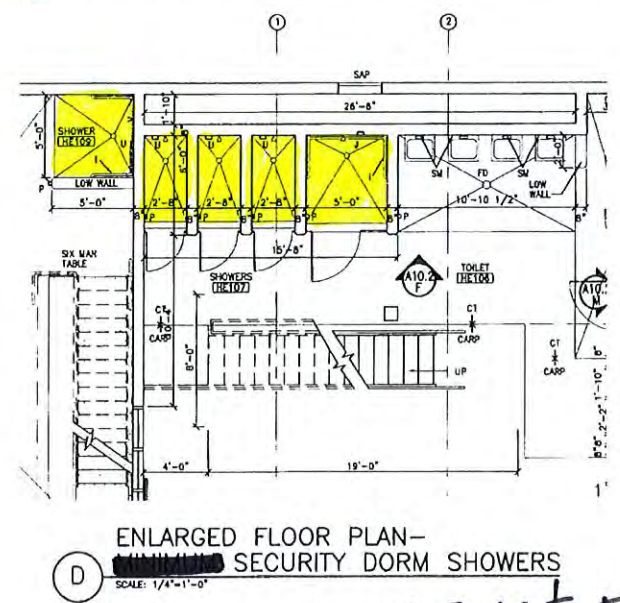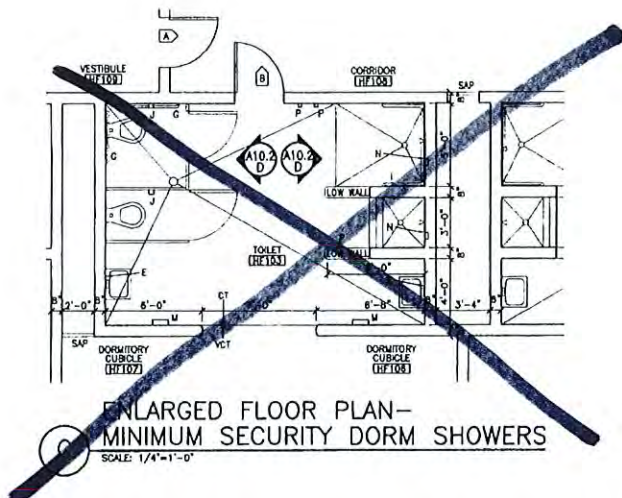

Women's HE 1st FL

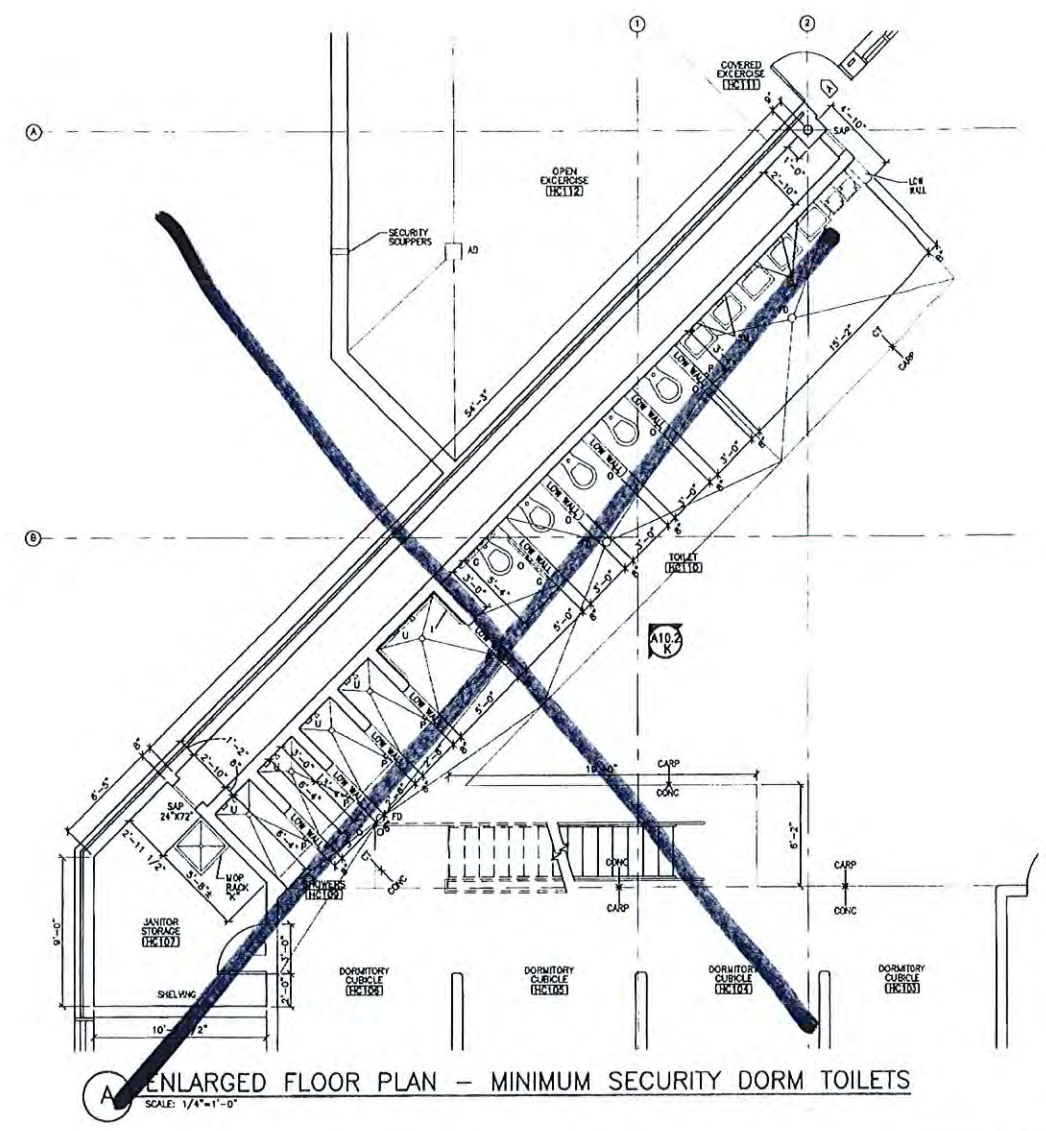


HA Special
1st FL

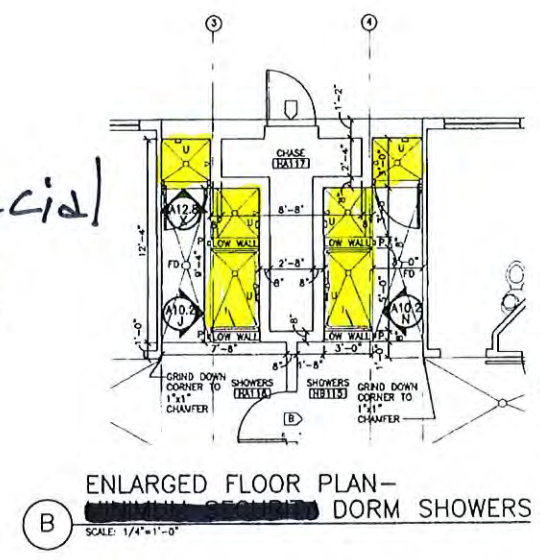


HB CLASS
1st FL


RECORD SET
DATE: DEC 3, 2001

The information shown on these documents is a composite of the Contract Documents and information furnished by the Contractor following the completion of construction. The design professional in copying the seal to these record documents certifies that any information furnished by the Contractor has been incorporated into these record documents; however, no certification is made regarding the accuracy and completeness of the information shown. Additionally, the design professional does not certify that any of the information shown has been verified on site by the design professional or his agents, no certification is made that the work has been constructed in complete accordance with the Contract Documents, and no certification is made that these documents include all addenda, change orders, field directives, and other modifications which may have been made during the course of construction.

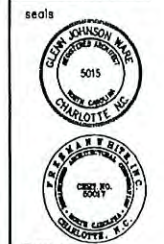


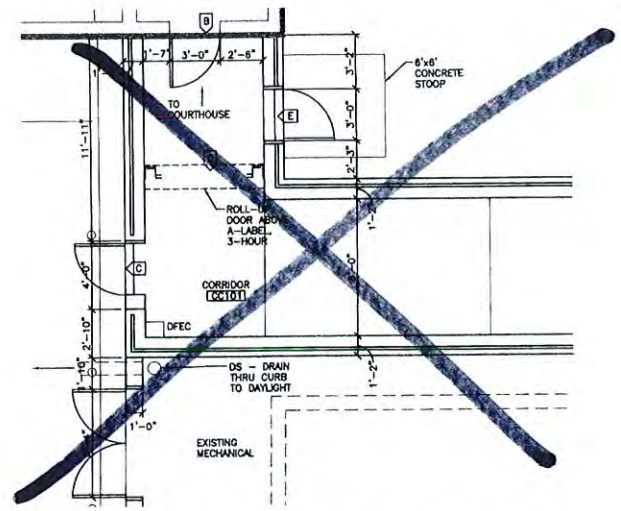


G ENLARGED FLOOR PLAN-1ST FLOOR
CORRIDOR TO COURTHOUSE - CC101
SCALE: 1/4"=1'-0"

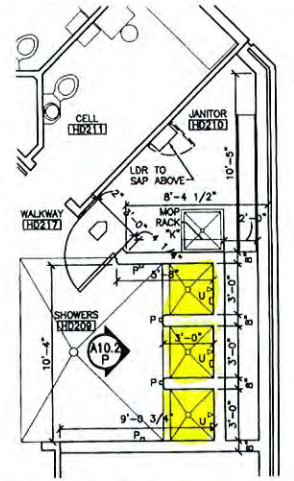


D ENLARGED FLOOR PLAN-2ND FLOOR
SHOWERS - HD209
SCALE: 1/4"=1'-0"
HD Medium

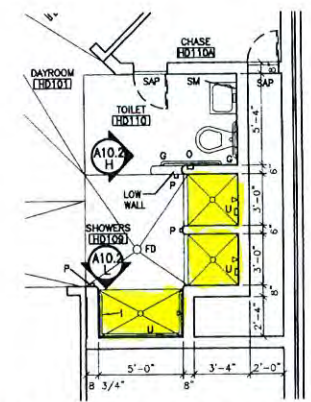


A ENLARGED FLOOR PLAN-1ST FLOOR
DORMITORY TOILETS-HD109
SCALE: 1/4"=1'-0"
HD Medium

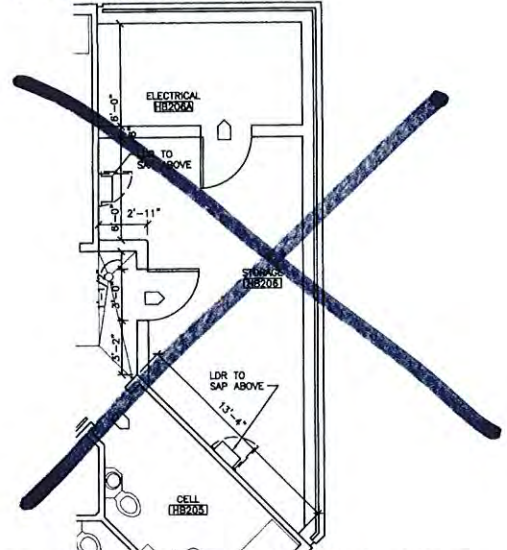


E ENLARGED FLOOR PLAN-2ND FLOOR
ELECTRICAL/STORAGE HB206A/HB206
SCALE: 1/4"=1'-0"

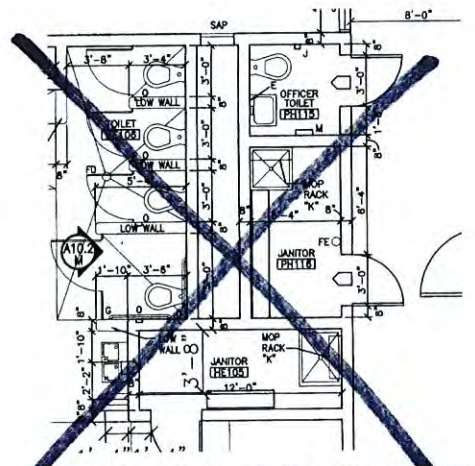

B ENLARGED FLOOR PLAN-1ST FLOOR
JANITOR'S CLOSET - HE105
SCALE: 1/4"=1'-0"

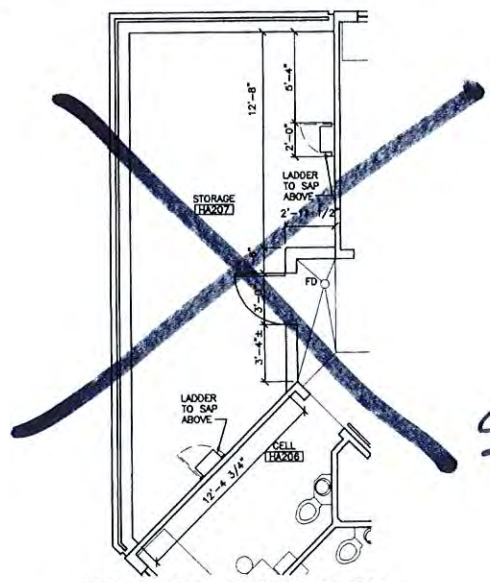

F ENLARGED FLOOR PLAN-
STORAGE-HA207
SCALE: 1/4"=1'-0"

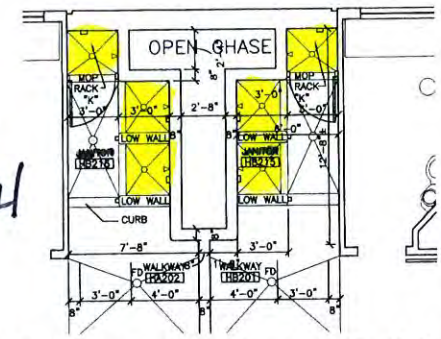

C ENLARGED FLOOR PLAN-2ND FLOOR
JANITOR'S CLOSETS - HB209
SCALE: 1/4"=1'-0"

*HA
Special*

*HB
CLASS*

RECORD SET
DATE: DEC. 3, 2001

The information shown on these documents is a composite of the Contract Documents and information furnished by the Contractor following the completion of construction. The design professional in applying his seal to these record documents certifies that only information furnished by the Contractor has been incorporated into these record documents; however, no certification is made regarding the accuracy and completeness of the information shown. Additionally, the design professional does not certify that any of the information shown has been verified on site by the design professional or his agents; no certification is made that the work has been constructed in complete accordance with the Contract Documents, and no certification is made that these documents include all addenda, change orders, field directives, and other modifications which may have been made during the course of construction.

charlotte nc

HENDERSON
COUNTY
DETENTION
CENTER

HENDERSONVILLE,
NORTH CAROLINA

ENLARGED
FLOOR PLANS

MISCELLANEOUS
AREAS

project number
■ 2271200

date
■ Sept. 13, 1999

seals



©1999 by
Grier Fripp Architects

drawn by

checked by

revisions

cpr number


date

includes sheets


sheet number

A4.5


THIS DRAWING REFLECTS ALL CHANGES
RECORDED AND NOTED ON THE DATE SHEET
AND SHOULD BE USED IN CONJUNCTION WITH
RECORDS WITH ANY OTHER RECORDS
SPECIFICALLY REFERENCED BY THIS SHEET.

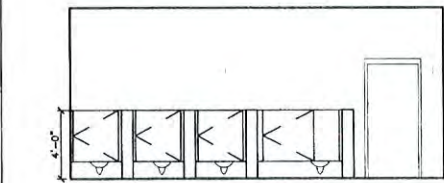

M TOILET HE106
SCALE: 1/4"=1'-0"

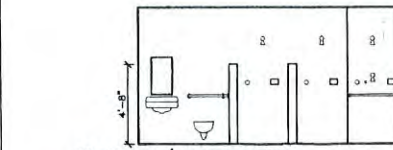

H TOILET/SHOWERS HD110 & HD109
SCALE: 1/4"=1'-0"

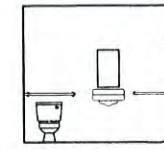


G TOILET MA106
SCALE: 1/4"=1'-0"



A SEARCH/CHANGING IN113
SCALE: 1/4"=1'-0"




N SHOWERS HB115
SCALE: 1/4"=1'-0"

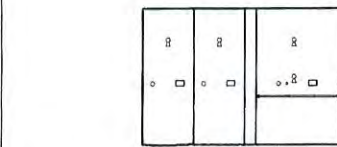


J SHOWERS HA116
SCALE: 1/4"=1'-0"




B MEN'S LOCKER ROOM IN129
SCALE: 1/4"=1'-0"

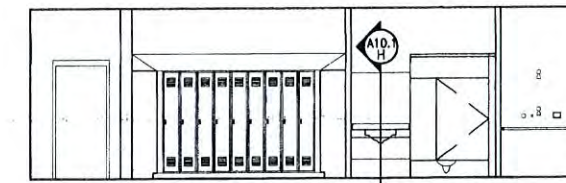


C WOMEN'S LOCKER ROOM IN130
SCALE: 1/4"=1'-0"

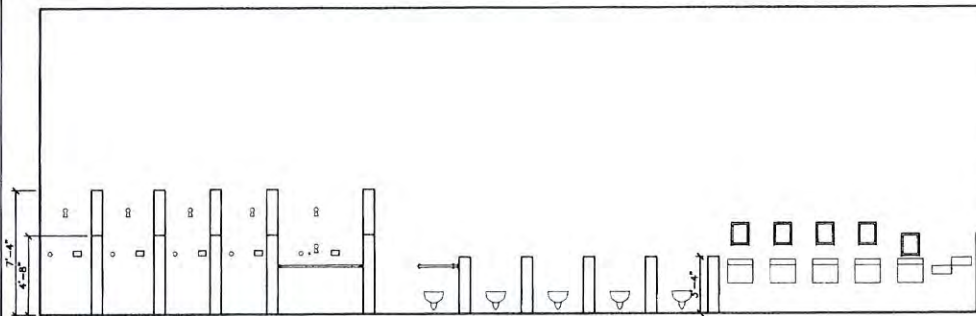

K SHOWERS/TOILET HC109 & HC110
SCALE: 1/4"=1'-0"

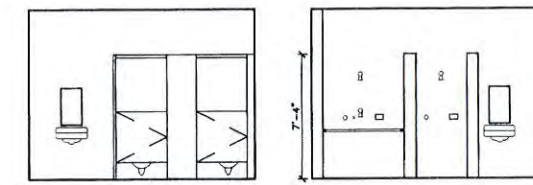


D TOILET HF103
SCALE: 1/4"=1'-0"

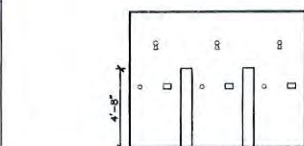


P TOILET HD209
SCALE: 1/4"=1'-0"



L TOILET HD109
SCALE: 1/4"=1'-0"

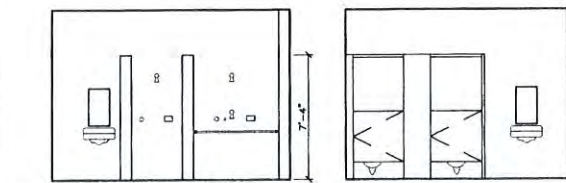

E TOILET HF114
SCALE: 1/4"=1'-0"

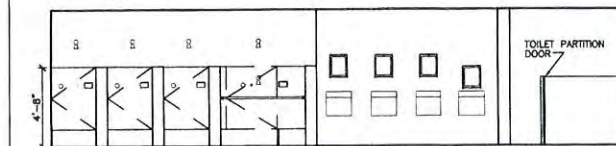

F SHOWERS/TOILET HE107 & HE106
SCALE: 1/4"=1'-0"

RECORD SET
DATE: DEC. 3, 2001

The information shown on these documents is a composite of the Contract Documents and information furnished by the Contractor following the completion of construction. The design professional in applying his seal to these record documents certifies that only information furnished by the Contractor has been incorporated into these record documents; however, no certification is made regarding the accuracy and completeness of the information shown. Additionally the design professional does not certify that any of the information shown has been verified on site by the design professional or his agents, no certification is made that the work has been constructed in complete accordance with the Contract Documents, and no certification is made that these documents include all addenda, change orders, field directives, and other modifications which may have been made during the course of construction.

FREEMANWHITE ARCHITECTS, d/b/a
Grier-Fripp Architects

charlotte nc

HENDERSON COUNTY DETENTION CENTER

HENDERSONVILLE, NORTH CAROLINA

INTERIOR ELEVATIONS

project number
■ 2271200
date
■ Sept. 13, 1999

seals



© 1999 By Grier-Fripp Architects

drawn by
■ PB, DT
checked by
■ G/JW

revisions

-
-
-
-

cpr number

date

includes sheets

-
-
-
-

THIS SHEET REFLECTS ALL CHANGES INCORPORATED INTO THE CONTRACT. ANY CHANGES NOT INCORPORATED INTO THE CONTRACT BEFORE RECORDING ARE NOT TO BE SPECIFICALLY REFERENCED BY THIS CPL.

sheet number

■ A10.2